DO NOT SCALE PAPER PRINT

G.G. Pg.

VIDE DRAWING 2069-3001-33

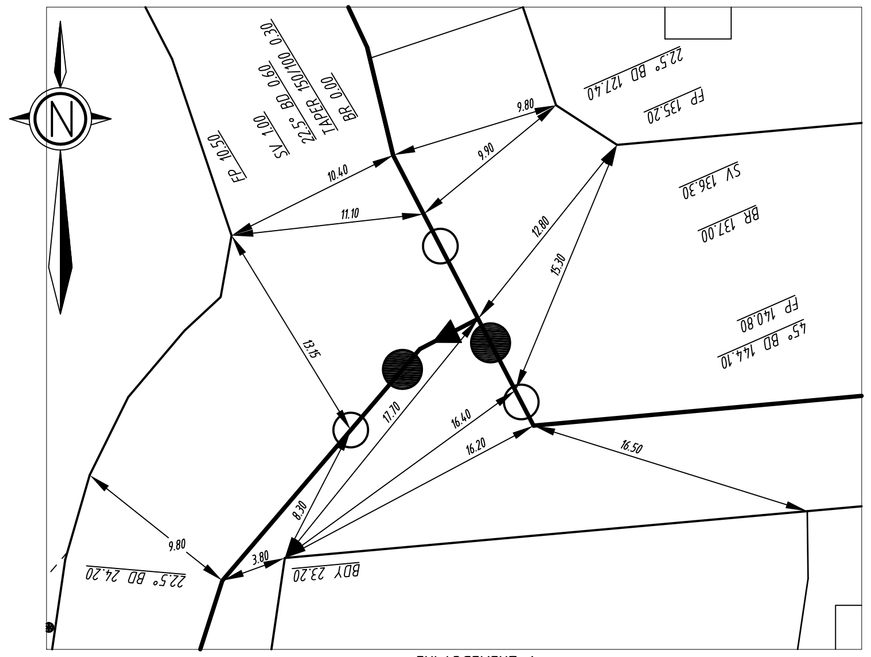

ENLARGEMENT 1
NOT TO SCALE

LAYOUT PLAN

0 5 10 20 30 m.

ENLARGEMENT 2
NOT TO SCALE

WATER FITTINGS TABLE

COUNT	FITTINGS
1	TEE SOC SOC DN 150 FLG dn 150
1	TEE SOC SOC DN 150 SOC dn 100
1	TEE FLG FLG DN 150 FLG dn 100
1	BEND 90xDN100 SOC dn80 FLG W/HEEL R/R
1	BEND 45 SOC SOC DN 100
1	FIRE PLUG TEE FLG FLG DN 100 FLG dn 80
1	BEND 11.25.5 SOC SOC DN 100
2	TAPER FLG FLG DN 150 dn 100
3	TEMP FIRE PLUG END - 100 - CONNECTOR FLG SOC DN 100 - CONNECTOR FLG SOC DN 100 - FIRE-PLUG - EXTN PIPE FLG DN 100 MSCL/THRUST COLLAR & dn 80 BR
3	TEMP FIRE PLUG END - 150 - CONNECTOR FLG SOC DN 150 - CONNECTOR FLG SOC DN 150 - FIRE-PLUG - EXTN PIPE FLG DN 150 MSCL/THRUST COLLAR & dn 80 BR
4	BEND 45 SOC SOC DN 100
4	TEE FLG FLG FLG DN 150
6	VALVE CI FLG DN 150
6	BEND 22.5 SOC SOC DN 100
7	BEND 45 SOC SOC DN 100
8	BEND 11.25 SOC SOC DN 100
9	CAST IRON LID CAST IRON BOX CAST IRON COVER CONCRETE SPACER 140MM
10	VALVE CI FLG DN 100
10	FIRE PLUG TEE SOC SOC DN 150 FLG dn 80
11	CONNECTOR FLG SOC DN 150
12	CONNECTOR FLG SOC DN 100
12	FIRE PLUG TEE SOC SOC DN 100 FLG dn 80

LEGEND

WATER / RECLAIMED

- Contract Boundary
- Existing Main
- Proposed Main
- Future Main
- Cap
- Blank Flange
- Gibault
- Flanged Reducer
- Temp F.P End
- DICL Flanged Spigoted Extension with Puddle Flange
- Socket Flanged Connector
- S/S Flanged Offtake Clamp
- Socketed Tee

Symbols based on AS 1100

- As Conn. Stop Valve
- As Conn. Fire Plug
- As Conn. Fire Plug Temp. End
- As Conn. Reducer
- Flanged Tee
- Spigoted Flanged Tee
- Socketed Flanged Tee
- Socketedx80 Flanged Bend
- Socketed Bend
- Flanged Bend
- Fire Plug / Air Valve
- Stop Valve Flanged
- Existing Fire Plug
- Existing Stop Valve
- Existing Meter
- Main Crossover

Sheet No	Length	Prog. Total	Pipe Discription
REFER SHEET 31			
ACTUAL			

FREE ASSET

Amendment -

Rev	Date	Drn.	Description.

AUTHORIZATION

Signature : Date : / /

Name :

CHARTERED ENGINEER

CONTRACTORS WORK SPACE

LOGOS NOT PERMITTED

AS CONSTRUCTED DETAILS

SOIL TYPE :	CLAY	
WATER TABLE :	N/A	Depth to WATER : N/A
BEDDING :	GRAVEL	
DATE CONSTRUCTED :	69-70	
Field Check :	CLS	
CERTIFIED BY :	CLS	DATE : 4/4/70
LICENSED SURVEYOR :		

CONTRACTOR / COMPANY NAME
CONTACT DETAIL (PHONE No.)

Government of South Australia

SA Water

© This drawing is the property of the South Australian Water Corporation and shall not be copied or modified in part or in whole without authorization.

CONSTRUCTION DRAWING RECEIVED Date :

CPC Issued Date : CONTRACT No. : 123/69

FOR FURTHER INFORMATION VIDE

WATER DISTRICT : Adelaide

COUNCIL : Adelaide

D.P. : L.D. : 120/d345/69

CADASTRE REFERENCE : 6612-34-h3 G.G.Date :

SOMEWHERE SOUTH
STAGE Z
POTABLE WATER IN MARITIME RD, TIDE ST, ATLANTIS AV, ANCHOR RD
LAYOUT PLAN

SHEET SIZE	SA WATER DOCKET NUMBER	REVISION
A1	90123/09	

SHEET 2 OF 5

DRAWING NUMBER 2069- 3001 - 32
YEAR NUMBER SHEET

BAR CODE

The accuracy of the information shown here is not guaranteed and no responsibility is accepted by the Crown,SA Water or their officers,agents or servants for any loss or damages caused by the reliance upon thisinformation, as a result of an error and or ommision or misdescription hereon, whether caused by negligence or otherwise.Standard SA Water Notes